



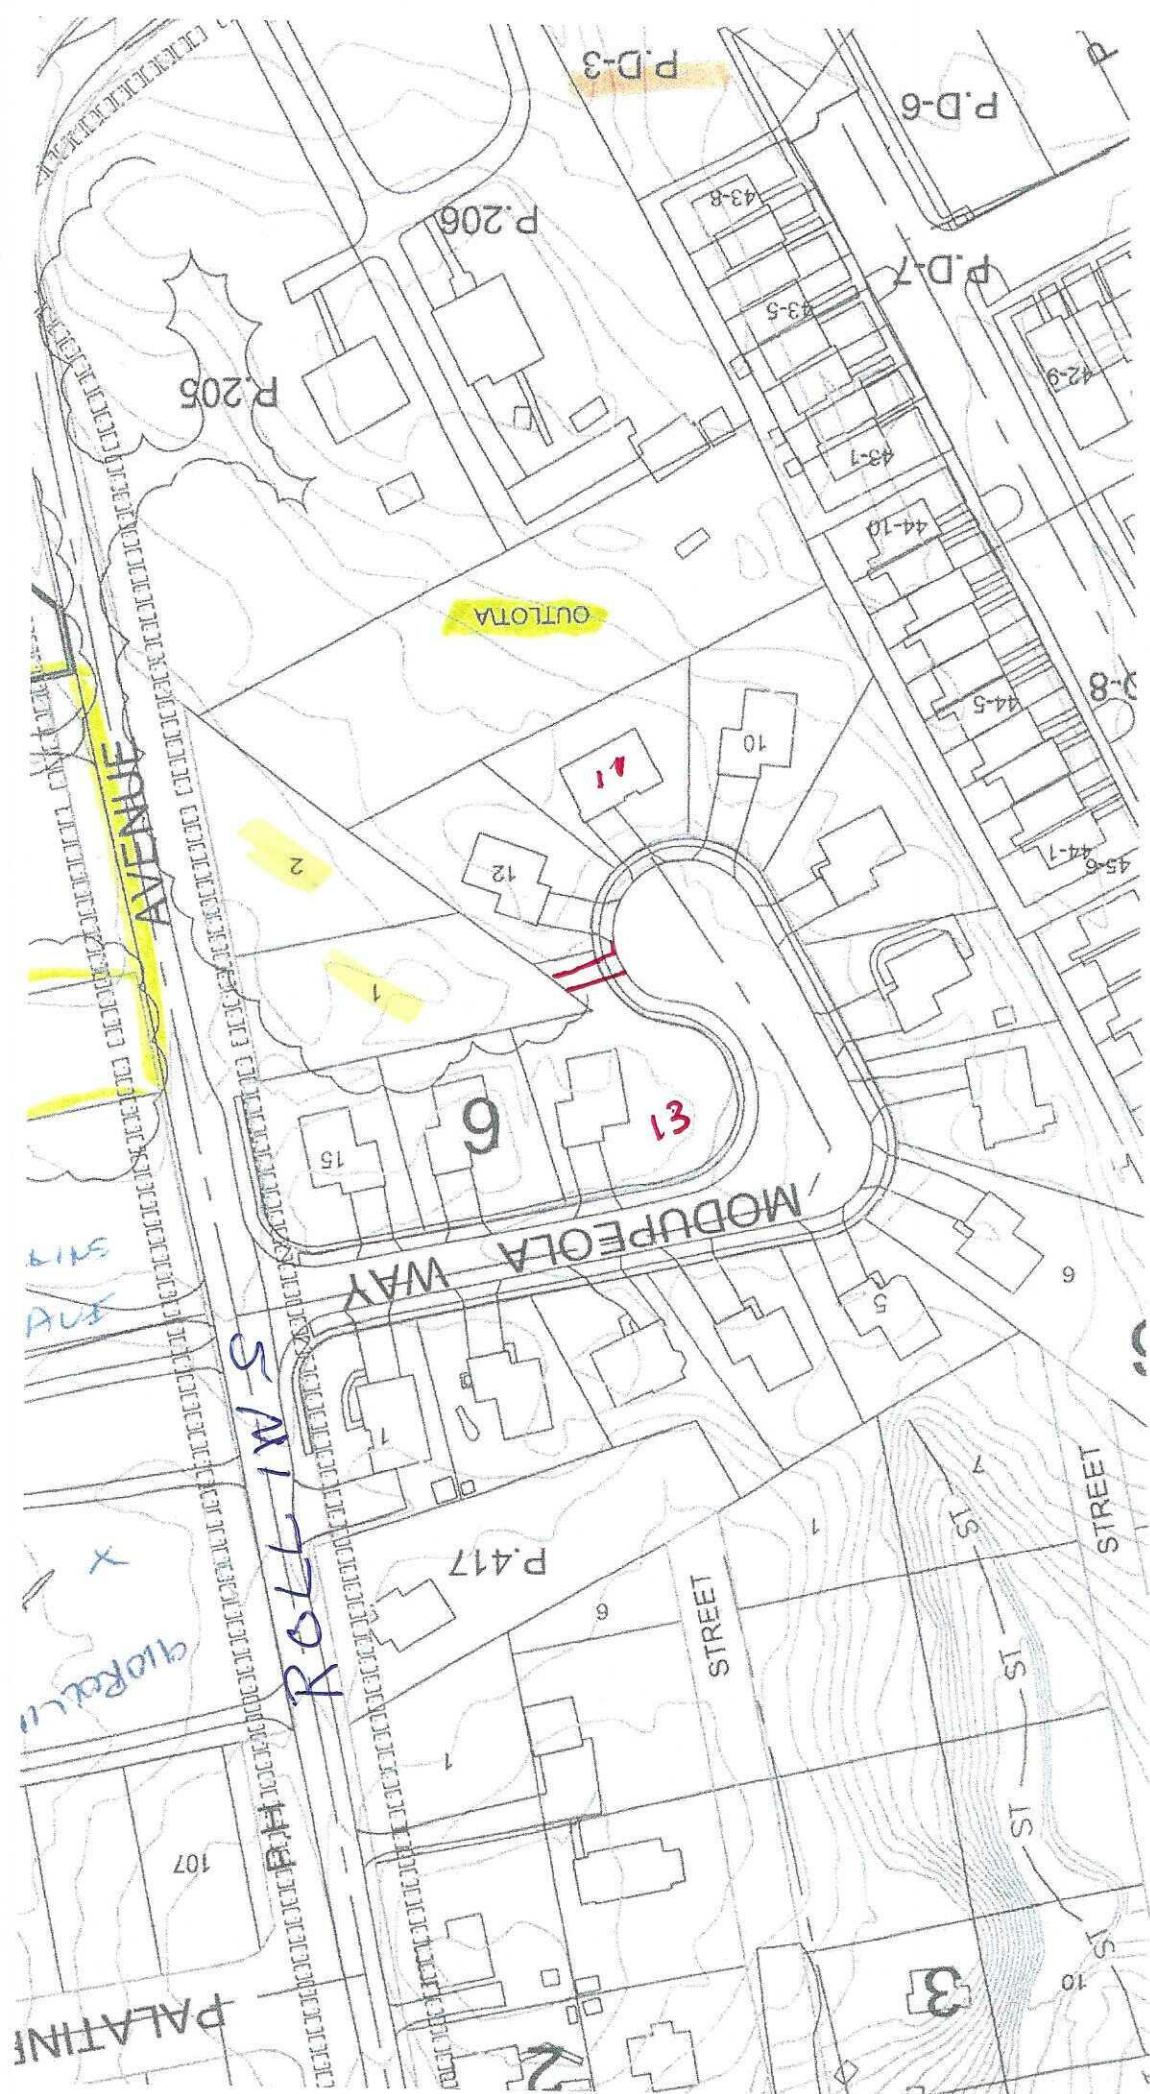

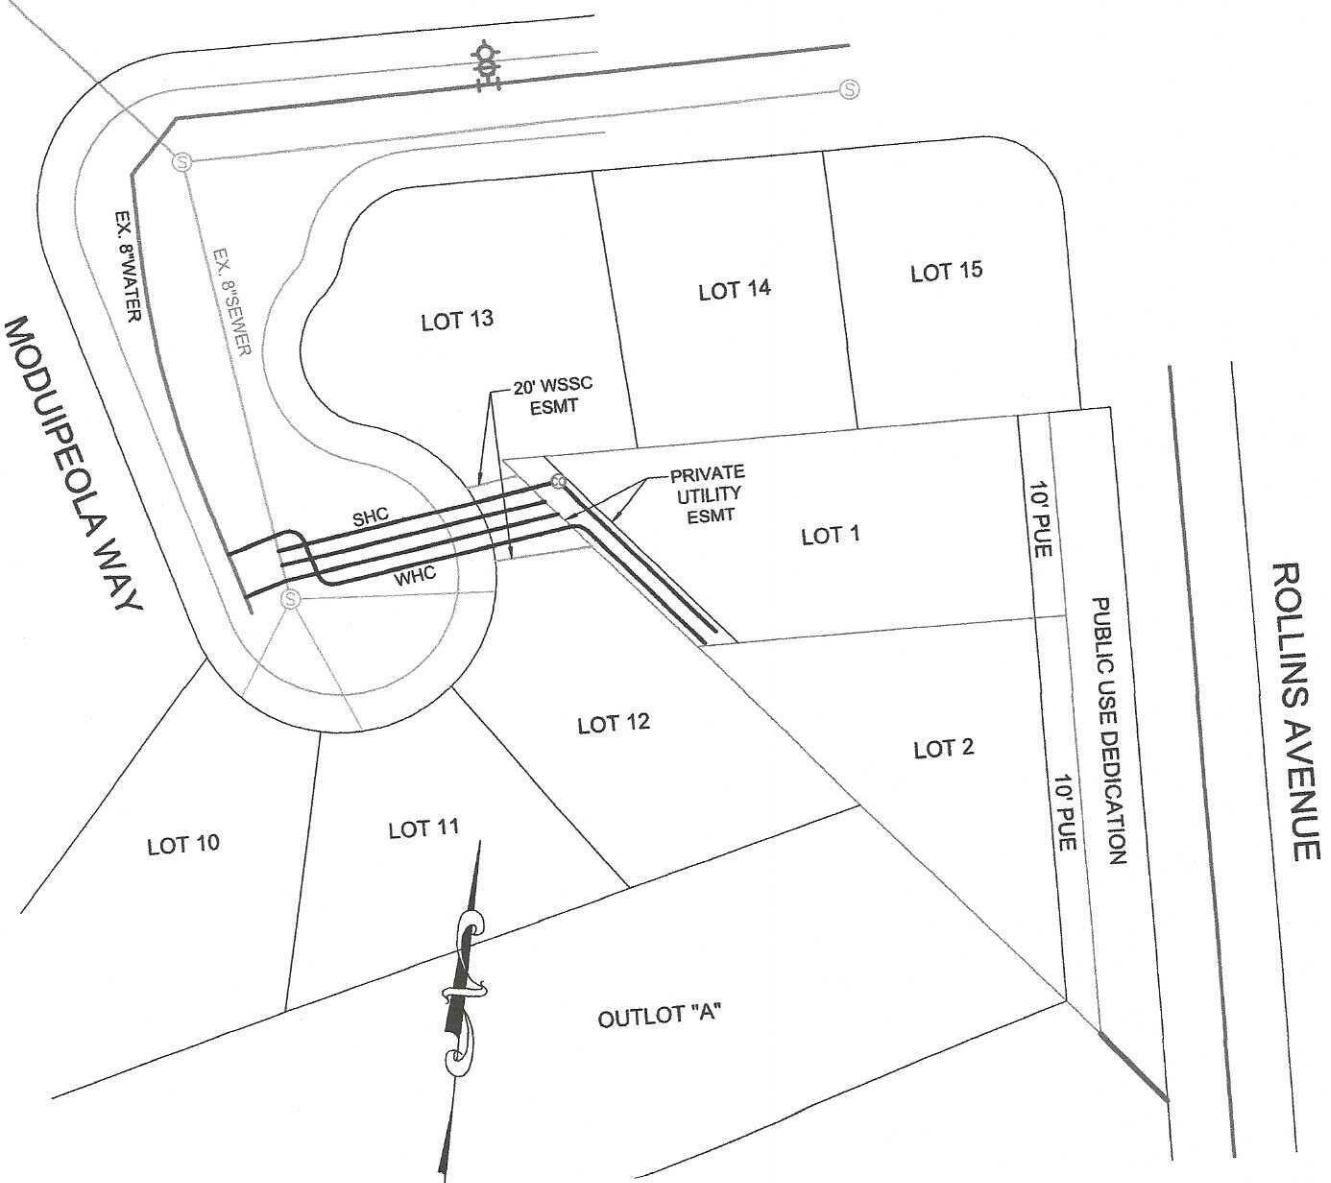

WATER & SEWER CONNECTION SKETCH

SCALE: 1" = 60'

FINAL FILMED APR 11 2007

PLAN FILMED

RELEASED 2-4-99

R/W'S ASSIGNED

SOIL BORINGS ORDERED

1/25/1998

RESTORATION SCHEDULE		
LOCATION	CONDO TYPE	RESTORATION TYPE
1. 201 COND. 35 X 35X	1	4 AND FINISH IN COND
2. 1401 ROLLINS AVE	1	4 AND FINISH IN COND
3. 1401 ROLLINS AVE	1	4 AND FINISH IN COND
4. 1401 ROLLINS AVE	1	4 AND FINISH IN COND
5. 1401 ROLLINS AVE	1	4 AND FINISH IN COND
6. 1401 ROLLINS AVE	1	4 AND FINISH IN COND
7. 1401 ROLLINS AVE	1	4 AND FINISH IN COND
8. 1401 ROLLINS AVE	1	4 AND FINISH IN COND
9. 1401 ROLLINS AVE	1	4 AND FINISH IN COND
10. 1401 ROLLINS AVE	1	4 AND FINISH IN COND

SEWAGE TREATMENT		
NO. OF UNIT	TYPE	SEWAGE FLOW (GPD)
15	1000 GPM (1000 GPD)	15000
TOTAL SEWAGE FLOW		15000

1. 1000 GPM (1000 GPD)
2. 1000 GPM (1000 GPD)
3. 1000 GPM (1000 GPD)
4. 1000 GPM (1000 GPD)
5. 1000 GPM (1000 GPD)
6. 1000 GPM (1000 GPD)
7. 1000 GPM (1000 GPD)
8. 1000 GPM (1000 GPD)
9. 1000 GPM (1000 GPD)
10. 1000 GPM (1000 GPD)

ALL LOTS TO BE SLOPED TO WITHIN 6" ABOVE OR 12" BELOW F.S. GRADE WITH NO MORE THAN 2% SLOPE. SEE PLAN FOR DETAILS.

1. 1000 GPM (1000 GPD)
2. 1000 GPM (1000 GPD)
3. 1000 GPM (1000 GPD)
4. 1000 GPM (1000 GPD)
5. 1000 GPM (1000 GPD)
6. 1000 GPM (1000 GPD)
7. 1000 GPM (1000 GPD)
8. 1000 GPM (1000 GPD)
9. 1000 GPM (1000 GPD)
10. 1000 GPM (1000 GPD)

LIMITS OF MILL-CORRECTION
NORTH PHASE FULL-SCALE
P.O. COUNTY OF W & T 1725
JAN. 28, 1958

1. 1000 GPM (1000 GPD)
2. 1000 GPM (1000 GPD)
3. 1000 GPM (1000 GPD)
4. 1000 GPM (1000 GPD)
5. 1000 GPM (1000 GPD)
6. 1000 GPM (1000 GPD)
7. 1000 GPM (1000 GPD)
8. 1000 GPM (1000 GPD)
9. 1000 GPM (1000 GPD)
10. 1000 GPM (1000 GPD)

ROLLINS AVENUE
EST. GRADE ON & APPROVED
P.O. COUNTY OF W & T 1322
APRIL 14, 1965


GENERAL NOTES
SCALE HOR. 1"=100'

1. All work to be done in accordance with the plans and specifications.
2. All work to be done in accordance with the plans and specifications.
3. All work to be done in accordance with the plans and specifications.
4. All work to be done in accordance with the plans and specifications.
5. All work to be done in accordance with the plans and specifications.
6. All work to be done in accordance with the plans and specifications.
7. All work to be done in accordance with the plans and specifications.
8. All work to be done in accordance with the plans and specifications.
9. All work to be done in accordance with the plans and specifications.
10. All work to be done in accordance with the plans and specifications.



Contract the Price Georges
County Department of Public Works
Department of Public Works
Department of Public Works

COUNTY MAP

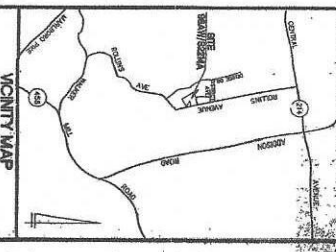

ITEM	REQUIREMENTS	IS	RECD
1. 1000 GPM (1000 GPD)	1000 GPM (1000 GPD)	1000 GPM (1000 GPD)	1000 GPM (1000 GPD)
2. 1000 GPM (1000 GPD)	1000 GPM (1000 GPD)	1000 GPM (1000 GPD)	1000 GPM (1000 GPD)
3. 1000 GPM (1000 GPD)	1000 GPM (1000 GPD)	1000 GPM (1000 GPD)	1000 GPM (1000 GPD)
4. 1000 GPM (1000 GPD)	1000 GPM (1000 GPD)	1000 GPM (1000 GPD)	1000 GPM (1000 GPD)
5. 1000 GPM (1000 GPD)	1000 GPM (1000 GPD)	1000 GPM (1000 GPD)	1000 GPM (1000 GPD)
6. 1000 GPM (1000 GPD)	1000 GPM (1000 GPD)	1000 GPM (1000 GPD)	1000 GPM (1000 GPD)
7. 1000 GPM (1000 GPD)	1000 GPM (1000 GPD)	1000 GPM (1000 GPD)	1000 GPM (1000 GPD)
8. 1000 GPM (1000 GPD)	1000 GPM (1000 GPD)	1000 GPM (1000 GPD)	1000 GPM (1000 GPD)
9. 1000 GPM (1000 GPD)	1000 GPM (1000 GPD)	1000 GPM (1000 GPD)	1000 GPM (1000 GPD)
10. 1000 GPM (1000 GPD)	1000 GPM (1000 GPD)	1000 GPM (1000 GPD)	1000 GPM (1000 GPD)

MAJOR AS BUILT DATA
CONTRACT NO. 415 (10/15/94)
INVESTIGATED BY: J. H. Smith
DATE COMPLETED: 10/15/94
TYPE: AS BUILT
DATE: 10/15/94
DRAWN BY: J. H. Smith
CHECKED BY: J. H. Smith

SECTION	DATE	BY	CHKD
1. 1000 GPM (1000 GPD)	10/15/94	J. H. Smith	J. H. Smith
2. 1000 GPM (1000 GPD)	10/15/94	J. H. Smith	J. H. Smith
3. 1000 GPM (1000 GPD)	10/15/94	J. H. Smith	J. H. Smith
4. 1000 GPM (1000 GPD)	10/15/94	J. H. Smith	J. H. Smith
5. 1000 GPM (1000 GPD)	10/15/94	J. H. Smith	J. H. Smith
6. 1000 GPM (1000 GPD)	10/15/94	J. H. Smith	J. H. Smith
7. 1000 GPM (1000 GPD)	10/15/94	J. H. Smith	J. H. Smith
8. 1000 GPM (1000 GPD)	10/15/94	J. H. Smith	J. H. Smith
9. 1000 GPM (1000 GPD)	10/15/94	J. H. Smith	J. H. Smith
10. 1000 GPM (1000 GPD)	10/15/94	J. H. Smith	J. H. Smith

WASHINGTON SUBURBAN SANITARY COMMISSION

WATER AND SEWER EXTENSION